



Exhibit G
to Leatherman
Declaration

3404
11/15/18

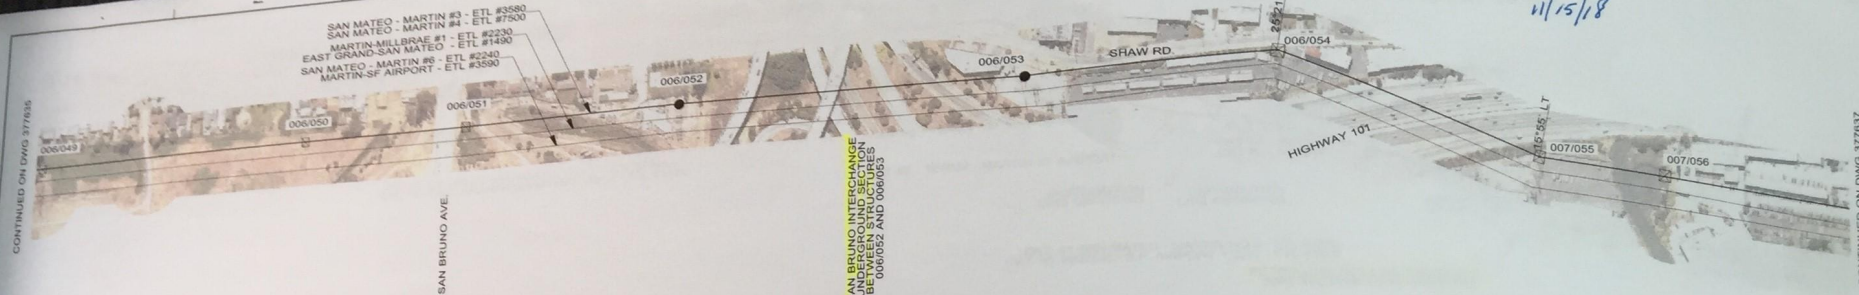

BLACK & VEATCH
FOR QUESTIONS ON REV 3 OF THIS DWG
PE: BEN J. SCHUCH 503-443-4216
DE: ERIC JOHNSON 503-443-4420

ACCEPTED
ENGINEERING DEPARTMENT
BY: Mark Galicia on May 01, 2018

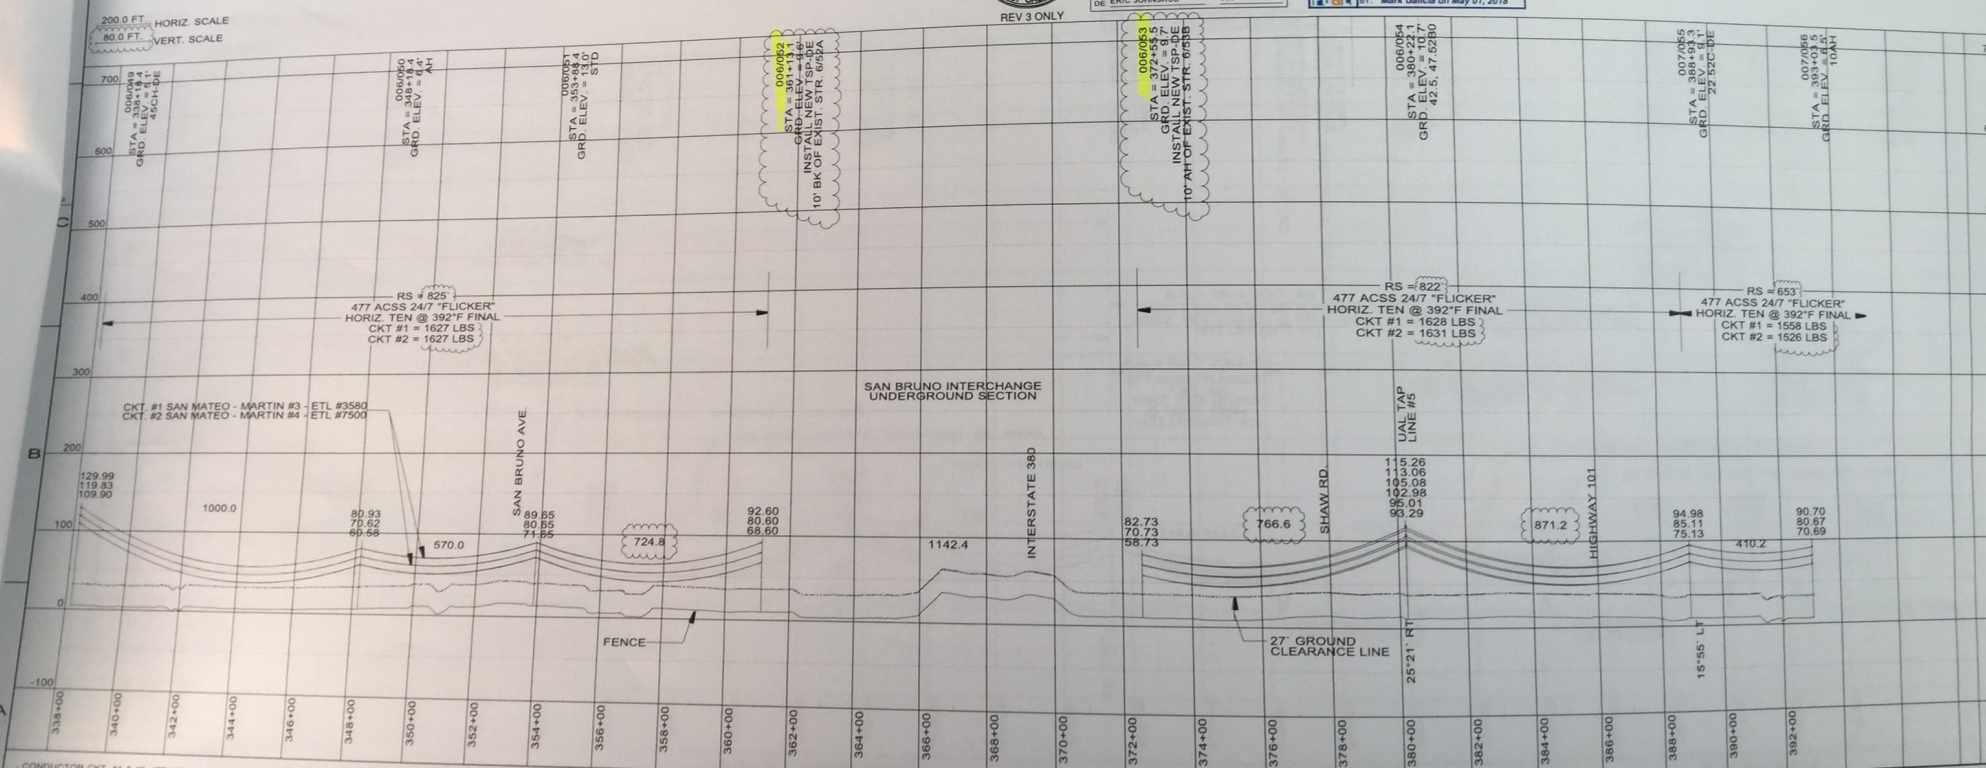

CONDUCTOR CKT #1 & #2 477 KCMIL ACSS 24/7 "FLICKER" SHOWN AT 392°F FINAL
CKT #1 MAX HORIZ. TENSION @ 25°F. 819W WIND 0° ICE, FINAL
STR 006/049 - STR 006/052 = 3427 LBS
STR 006/053 - STR 007/056 = 3473 LBS
CKT #2 MAX HORIZ. TENSION @ 25°F. 819W WIND 0° ICE, FINAL
STR 007/055 - STR 007/057 = 3987 LBS
STR 006/049 - STR 006/052 = 3427 LBS
STR 006/053 - STR 007/056 = 3473 LBS
STR 007/055 - STR 007/057 = 3987 LBS

-STRUCTURE DATA SHEET: 217643
-DIVISION: SAN MATEO
-INSULATOR DISTRICT: AAA
-LOADING DISTRICT: LIGHT
-VERTICAL DATUM: NAVD88
-LINE NO.: CKT #1 SAN MATEO-MARTIN #3- ETL 3580
CKT #2 SAN MATEO-MARTIN #4- ETL 7500

REV	DATE	DESCRIPTION	JOB NO	DWG	CHKD	BY	APPD	DATE
1	04/02/18	REMOVED TSP'S 6/53A, 6/53B, 6/52A, AND 6/52B	14007360	REV	REV	REV	REV	
2	07/21/03	INSTALLED TSP'S 6/53 AND 6/52	14007361	REV	REV	REV	REV	
3	07/21/03	RECORD SAN MATEO-MARTIN #4	1042145	CD	AE	PN	PN	
4	07/21/03	WITH 477 ACSS (24/7 STR)	1042145	CD	AE	PN	PN	
5	07/21/03	AS-BUILT REVISION	1042145	CD	AE	PN	PN	

PLAN AND PROFILE
SAN MATEO-MARTIN NO 3 & NO 4
115KV TOWER LINE
DEPARTMENT OF ENGINEERING
PACIFIC GAS AND ELECTRIC COMPANY
SAN FRANCISCO, CALIFORNIA

MICROFILM
BILL OF MATERIALS
DWG LIST
SUPPLY
SUPPLY BY
SHEET NO 7 OF 13
377636